✽✽コノ部品ノ構成個数ヲ記入 NUMBERS REQUIRED ON THIS DRAWING
✽改正記号ハ部品区分材料表ニヨル最新ノモノニヨルコト SEE THE PARTS LIST FOR THE LATEST DWG.NO.
補用対象部品ニハ「1」ヲ付与スル FILL "1" FOR SPARE PARTS

番号 ITEM NO.	品番 ITEM MARK	✽図面番号 DWG. NO.	✽✽一式分個数 QUANT.	名称 PART NAME	材質 MATERIAL	記事 REMARK	補用 C N
1	✽ CA	本図ニヨル THIS DWG	1	取付説明書（英文） INSTALLATION MANUAL	上質紙	55kg/連	2
KA	✽ CA	本図ニヨル THIS DWG	1	取付説明書（表） INSTALLATION MANUAL			2
KI	✽ CA	本図ニヨル THIS DWG	1	取付説明書（裏） INSTALLATION MANUAL			2

~~KDBQ44B60~~ ⚠改正前 BEFORE REVISION ⇩
KDBQ44B60
KDBQ44BA60A
⚠改正前 BEFORE REVISION

⚠改正前 BEFORE REVISION

~~1P107764-1A~~ ⚠改正前 BEFORE REVISION ⇩
~~1P107764-1B~~ ⚠改正前 BEFORE REVISION

(KA)

(KI)

注）1. 紙ノ大キサハ420×297（A3サイズ）トスルコト。
2. 色ハ全テ黒色トスル。
3. 本取付説明書ニ対シテハ、版下ヲ提供スル。

NOTE)1. PAPER SIZE A3:420×297
2. BLACK TO BE FOR PRINTING.
3. BLOCK COPY WILL BE SUPPLED.

Daikin Air Conditioners Panel Spacer Installation manual

KDBQ44B60・60A
KDBQ44BA60A

Caution : Before installation, read this safety instruction. 1P107764-1C

Combination table

Panel spacer	KDBQ44B60 KDBQ44B60A KDBQ44BA60A
Decoration panel	BYFQ60BW1 BYFQ60BAW1

Contents of kit

Check if following parts are included with your kit.

Name	Panel spacer frame	Resin corner part	Fixing metal	Screw
Quantity	4 PCS.	4 PCS.	4 PCS.	28 PCS.
Shape・number	①	②	③	④ M4×12 Tapping screw (Class 2)

Name	Sealing material	
Quantity	2 PCS.	2 PCS.
Shape・number	⑤	⑥

Caution

- When the Panel Spacer is installed, it is not possible to have 2-way air outlet.
- Refer to the installation manual for both indoor unit and the Panel spacer for its installation.

❶ Preparation of the decoration panel

- Handle the decoration panel with care.

Never place the panel face down, or lean the panel against wall or place on the projective object.
(It causes the dent or damage of the surface of the panel or damage of swing motor.)

(1) Remove the suction grill from the decoration panel.
(Refer to the installation manual of the decoration panel how to remove.)
(2) Place the panel face down on the corrugated board or the vinyl sheet to protect the surface of the panel.

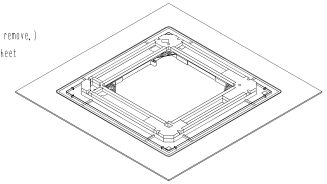

❷ Installation of the indoor unit

Adjust the height of the indoor unit.

Be sure the piping will not contact with the ceiling joist etc. after adjusting the height.

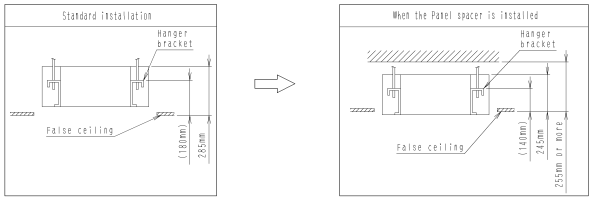

❸ Assembly of panel spacer

(1) Assemble the panel spacer frame ① and the plastic corner joint ② temporarily. (2) Fix with the screws ④ from the top. (4 screws in each corner)

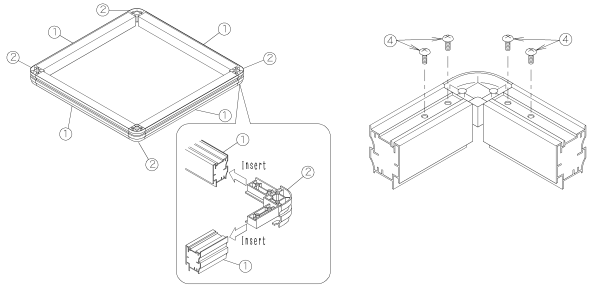

❹ Fixing to the decoration panel

(1) Set the fixing metal ③ on each corner with screws ④. (2) Place the panel spacer assembled in item ❸Assembly of panel spacer of the above on the outer frame of the decoration panel. (3) Fix the panel spacer to the fixing metal ③ with screws ④ (4 portions).

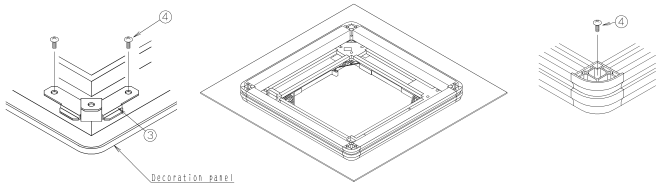

❺ Adhesion of the sealing material

Adhere the sealing material ⑤ ⑥ on the upper face of the panel spacer in the order of ⑤ and ⑥.

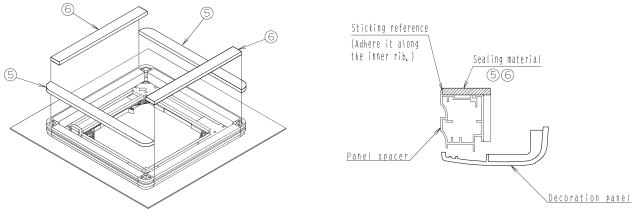

❻ Installation of the decoration panel

Install the decoration panel to the indoor unit according to the installation manual of decoration panel.

The panel spacer is not firmly fixed to the decoration panel, so that never hold the panel spacer directly or lean the decoration panel extremely.

1P107764-1C

~~1P107764-1B~~ ⚠改正前 BEFORE REVISION ⇧
~~1P107764-1A~~ ⚠改正前 BEFORE REVISION

適合規格欄

冷媒圧ヲ受ケナイ部品	⓪
DP2.8	1
DP3.3	2
DP4.14	3
ソノ他圧力	9

共用先	設・区	配布
住・本部		
汎・本部		
セ・本部		
圧・開発		

登録DAPICS（コード二〇ヨリヲ記入）
00・10・20・50・60・70

配布先
KOWA・S・B
オーケー

部番 ITEM	塗装箇所 PLACE	塗装種別 PAINT	素地 FOUND	工程 PROCESS	仕上色 COLOR	艶 GLOSS	塗装（マタハ備考） REMARK

表示寸法許容差/公差 TOLERANCE 重ね寸法許容差/公差 NOT INDICATED

A	BN05076A	05/07/06	岡田
7	RoHS対応ニヨル TO COPE WITH ROHS		岡田
C級	機構系 有・無 INTERCHANGEABILITY YES・NO		TEOTB
A	BR04354	04/09/27	SAKASHITA
7	適用機種名追記 ADDITION OF APPLICABLE MODEL NAMES		NISHI
C級	機構系 有・無 INTERCHANGEABILITY YES・NO		

KDBQ44B60
据付説明書（取付説明書（英文））
INSTALLATION MANUAL

作図治業 DRAWING DESIGN

ダイキン工業株式会社 DAIKIN INDUSTRIES, LTD 尺度 SCALE

承認 APPROVED	照査 CHECKED	設計 DESIGNED	製図 DRAWN
	坂下	坂下	MT010

作成日 DATE 19 03. 01. 21
部品コード PART CODE JA942500

1P107764C